

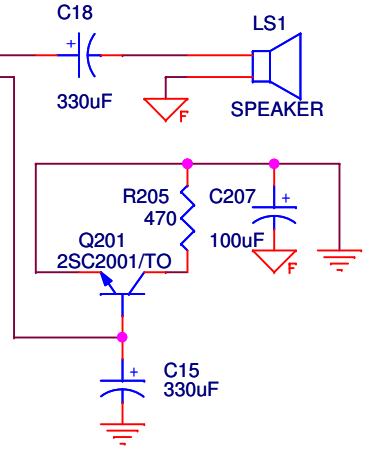
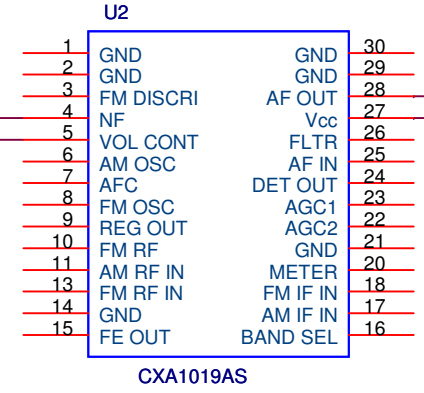
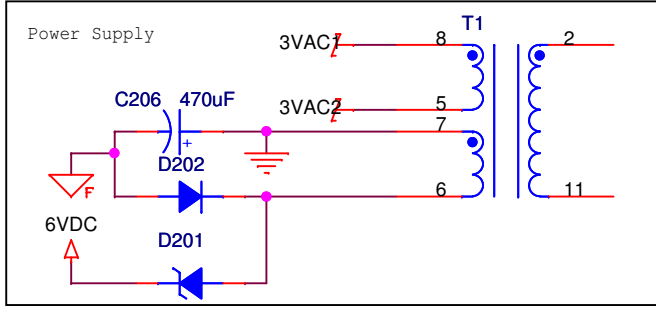


C8 900Hz Alarm 40mv Pk-Pk
Not controlled by Vol Knob

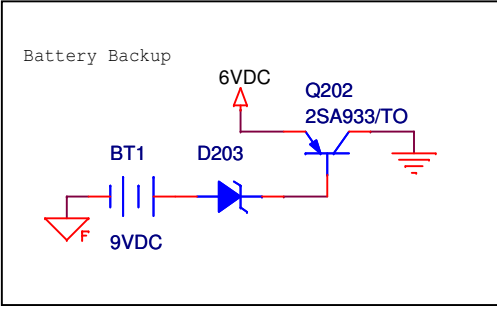

C107 Charges within 500ms to bias Q1 for min and max VOL (1.2v - 0.125v)

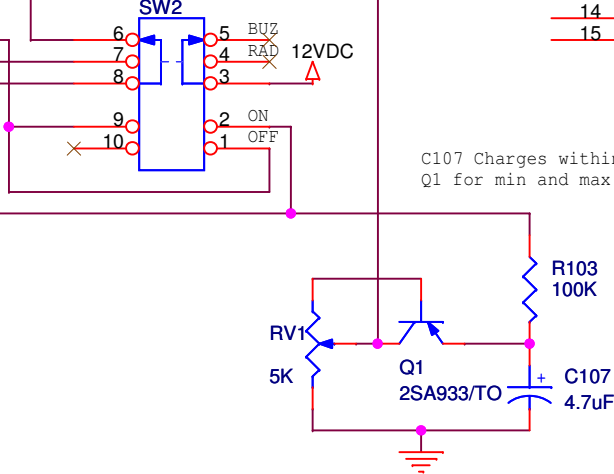

Title		
Clock Radio (Doug Gray) - http://www.starkgray.net/clock/		
Size A	Document Number <Doc>	Rev A
Date: Sunday, November 19, 2006	Sheet 1 of 1	1